
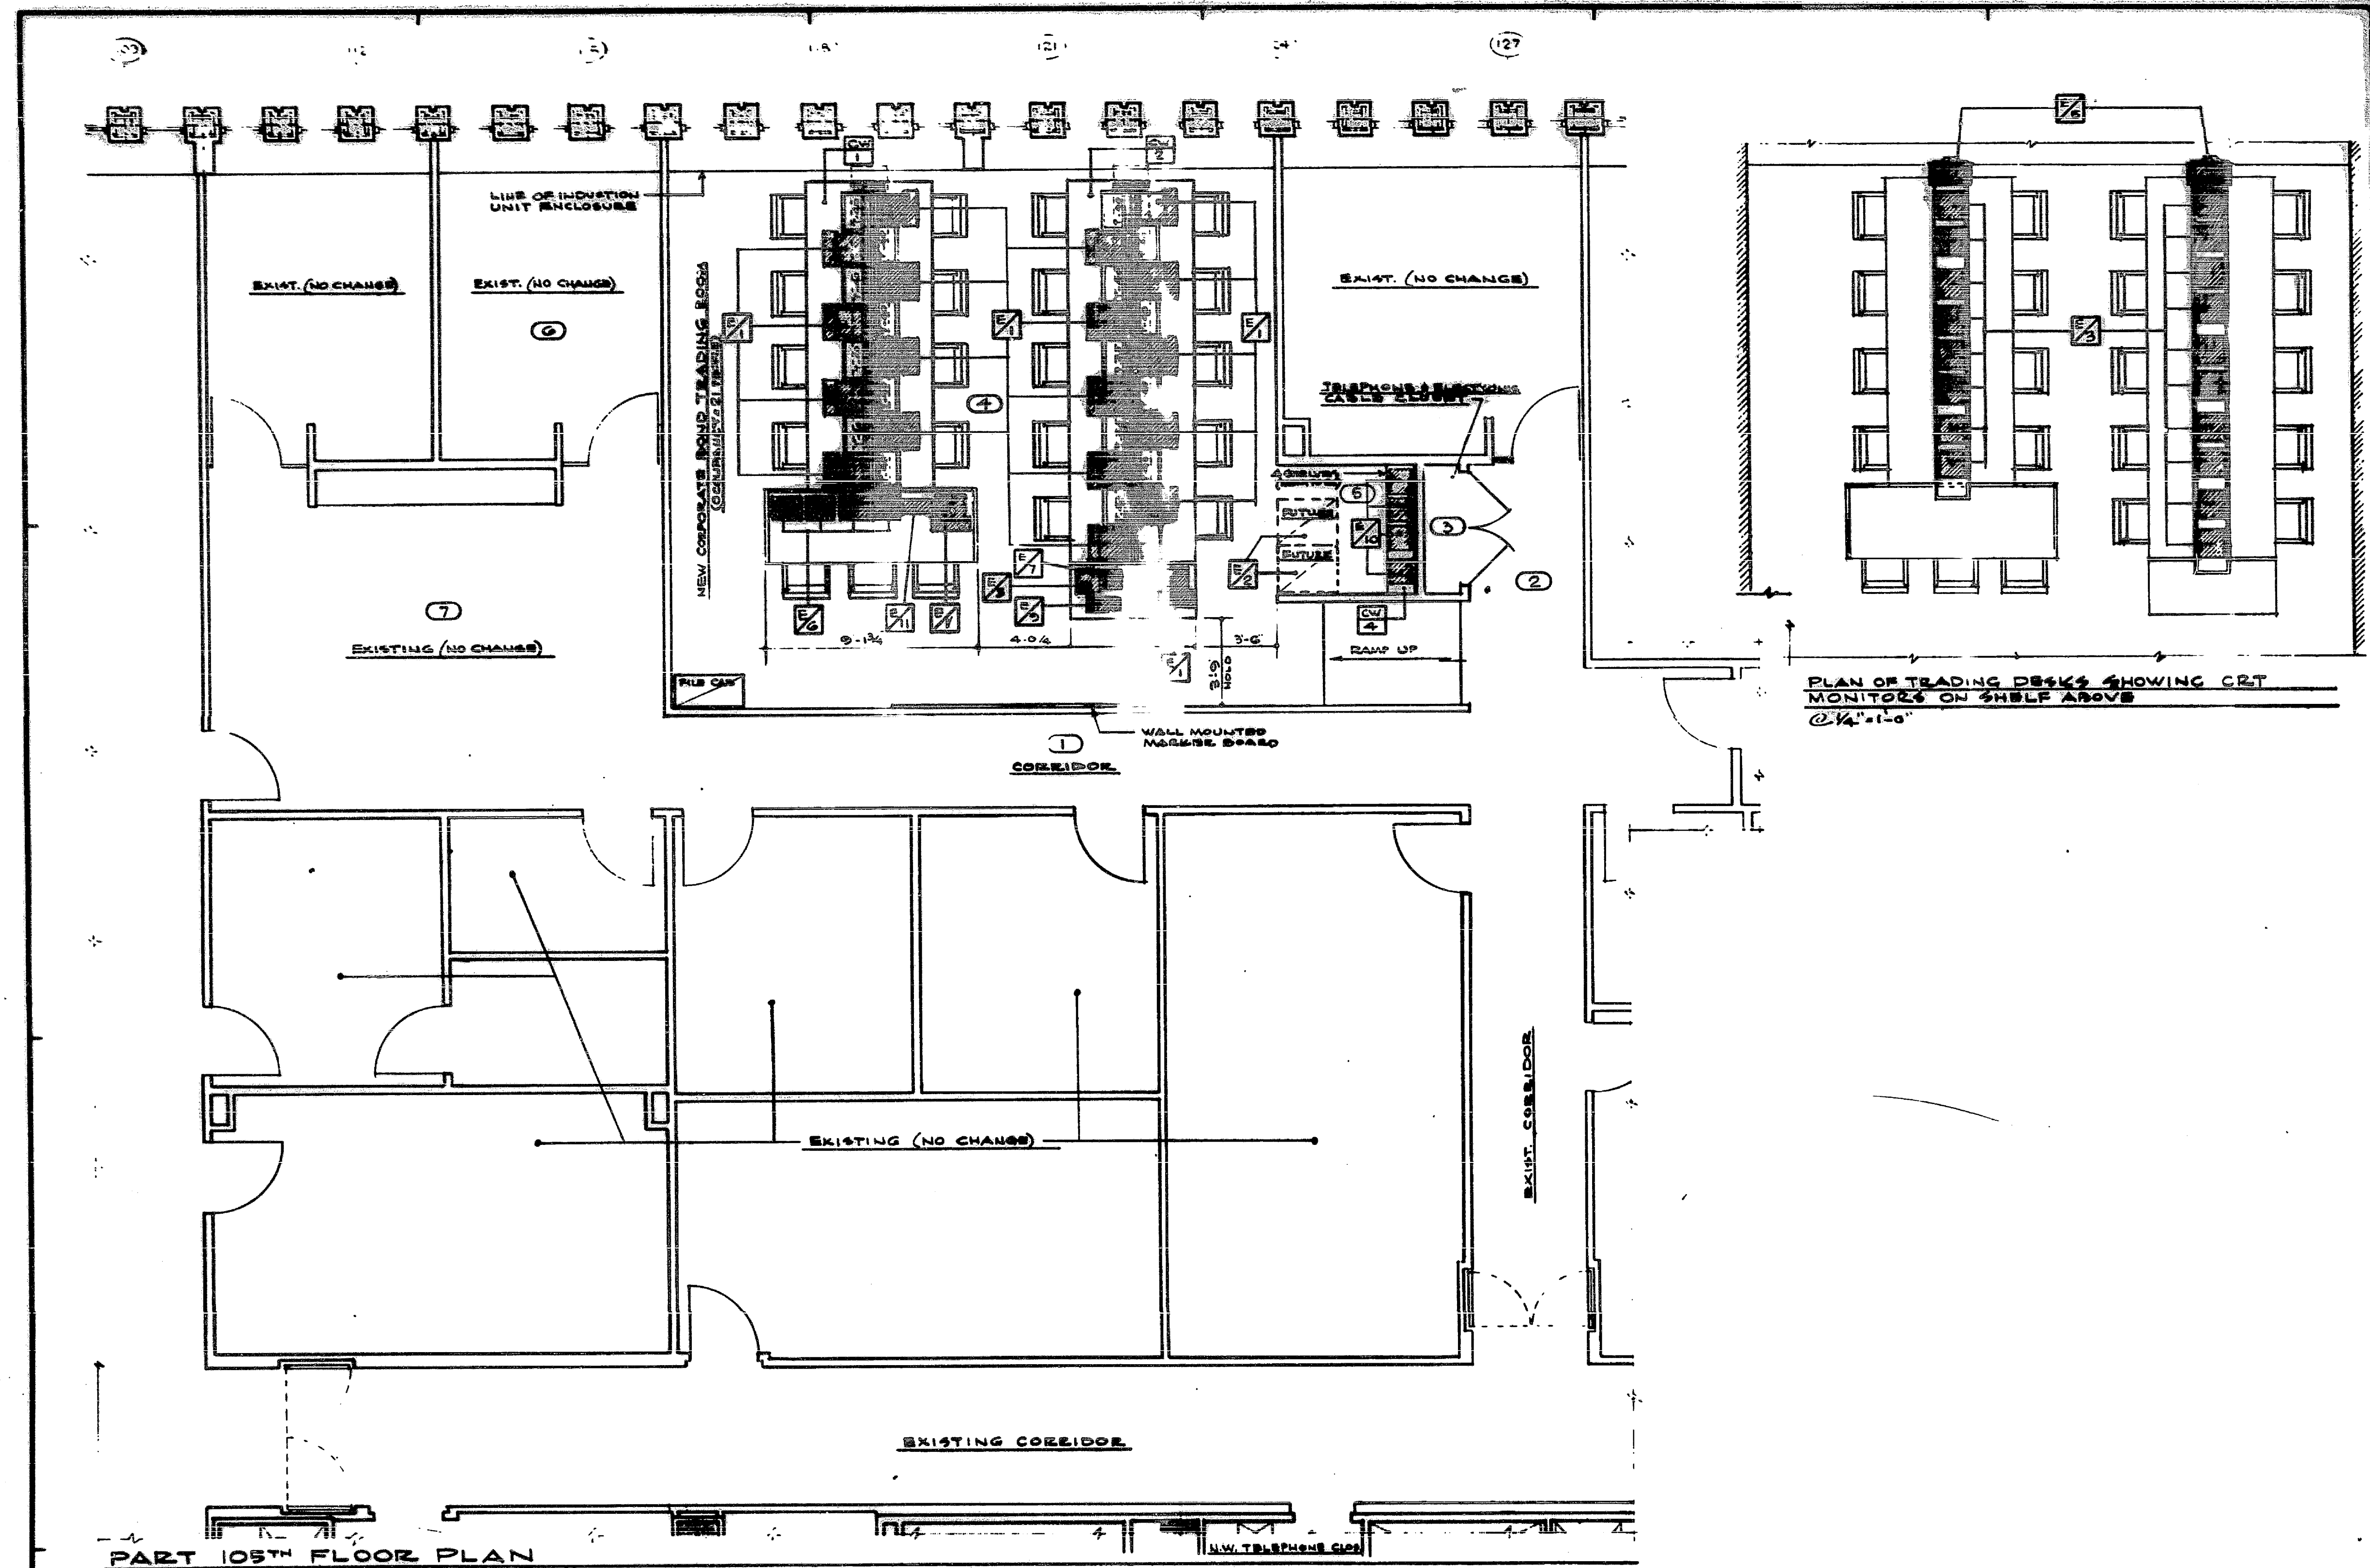


A-105  
Cantor Fitzgerald  
New Corporate Bond  
105F-6

DRAWING NUMBER

DRAWING NUMBER


DRAWING NUMBER

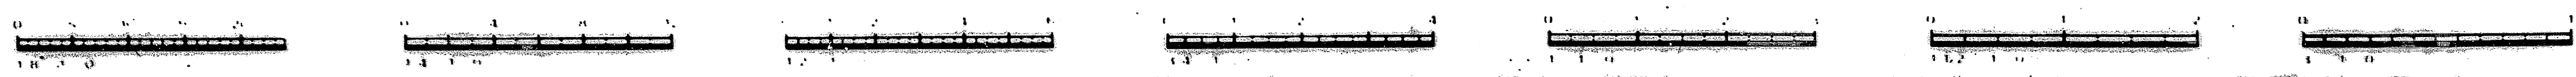

PART 105TH FLOOR PLAN  
@ 1/4\"/>

ELECTRONIC EQUIPMENT SCHEDULE									
SYMBOL	DESCRIPTION MANUFACTURER OR SUPPLIER	MODEL NO.	ELECTRICAL REQUIREMENTS			REMARKS	SYMBOL	DESCRIPTION MANUFACTURER OR SUPPLIER	MODEL NO.
			VOLTS	AMPS	WATTAGE				
E1	CRT MONITOR & KEYBOARD DATA MEDIA	DT 63/1 OR EXCL. #52	120V	1.0	—	SET ON DESKS	E2	PRINTER TELETYPE	—
E2	COMMUNICATIONS EQUIPMENT	—	120V	—	400W MAX.	—	E3	KEY BOARD TELETYPE	—
E3	CRT MONITOR 15" GALILEO	GD3-15	120V	1.0	—	SET ON SHELVES ABOVE DESKS	E4	CRT MONITOR DATA MEDIA	DT 63/1 OR EXCL. #52
E4	CRT MONITOR QUOTRON	—	120V	—	85W	—	E5	KEYBOARD QUOTRON	—
E5	CRT MONITOR ELECTRONICS	—	120V	1.0	—	FOR TELETYPE INFORMATION	—	—	—
E6	PRINTER CENTRONICS	H-80-1	120V	1/3	—	SET ON DESK	—	—	—
E7	SET MONITOR TELETYPE	—	—	—	—	SET ON COUNTER	—	—	—

SYMBOL LEGEND	
○	SPACE NUMBER SYMBOL
□	ELECTRIC OR ELECTRONIC EQUIPMENT NUMBER, SEE SCHEDULE THIS SHEET
■	ELECTRIC OR ELECTRONIC EQUIPMENT INDICATION
□	40 LINE TELEPHONE TUBE 1/4\"/>

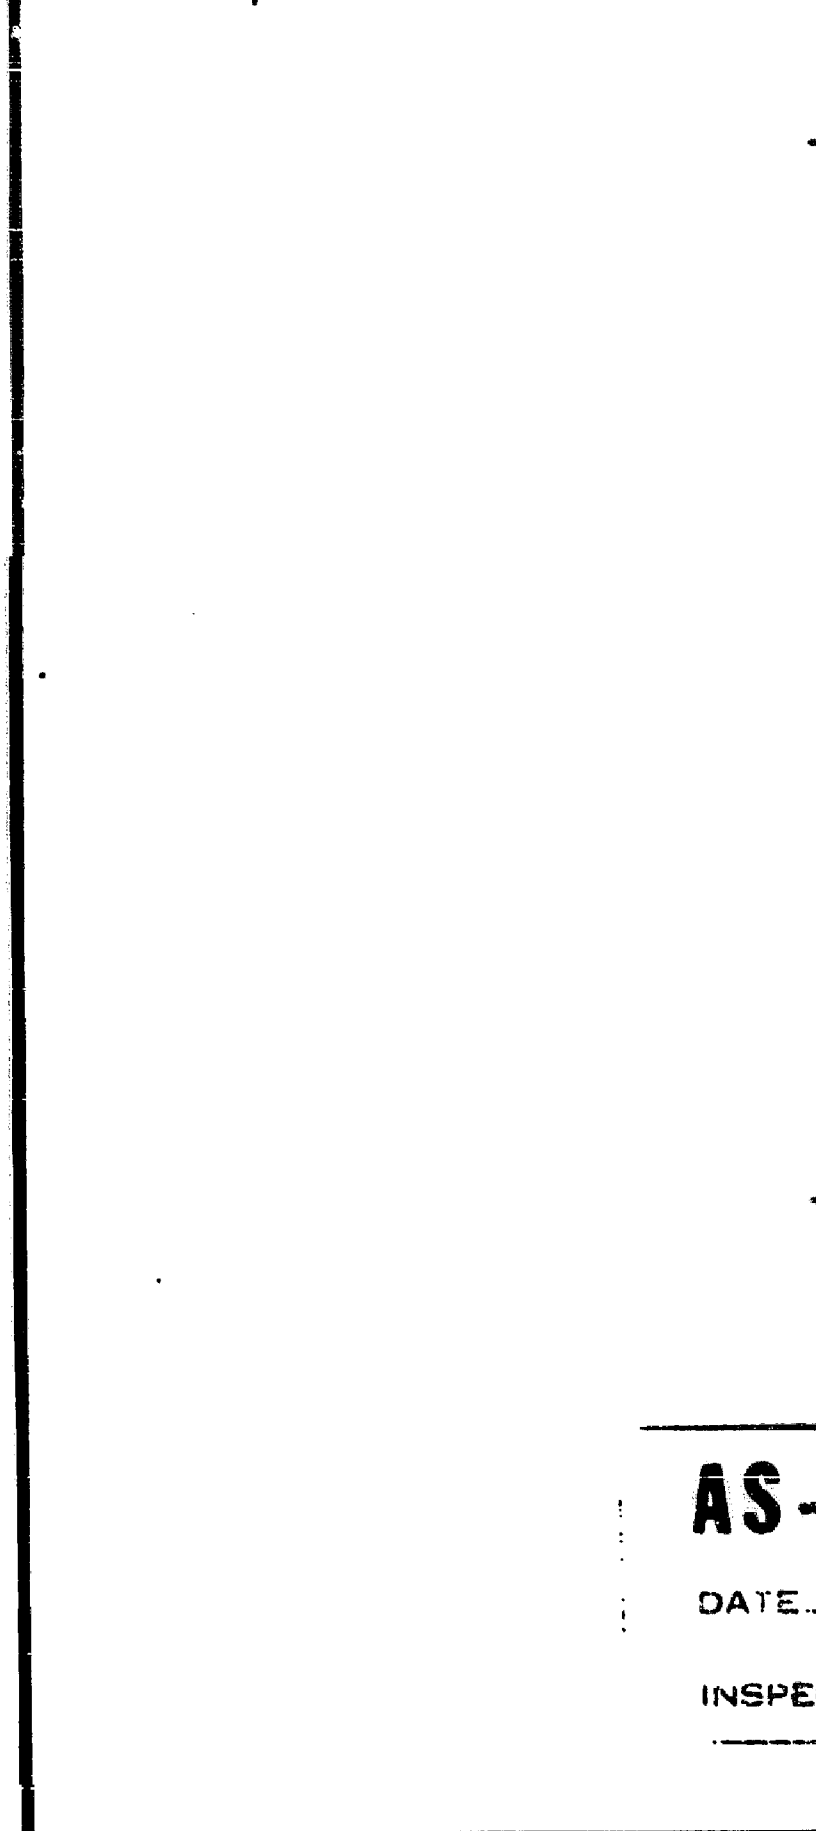

REVISION			
NO.	DATE	REVISION	BY
1	4-29-85	GENERAL REVISION TO CONFORM TO AS BUILT CONDITIONS	JFP

PHASE  
**F**  
TAA NO. 3104  
AS BUILT DWG.  
5-1-85

IF THIS DRAWING IS NOT 24"x36" IT IS  
A REDUCED PRINT SCALE ACCORDINGLY



CHARLES D. FLAYHAN ASSOCIATES, INC.  
880 CANAL STREET, STAMFORD, CT 06902  
203 348 4100

DATE	ISSUED TO	PR	TR
10-25-84	C.F.C., C. NICHOLAS, PROJECT MGR.	12	—
11-7-84	C.F.C., C. NICHOLAS, PROJECT MGR.	8	—
12-7-84	PORT AUTHORITY FOR APPROVAL CIVILS. CORP. FOR DIS. C.F.C., FOR RECORD	10	1
1-10-85	PORT AUTHORITY FOR APPROVAL CIVILS. CORP. FOR INFORMATION C.F.C., FOR RECORD	3	1
5-3-85	PORT AUTHORITY "AS BUILT"	0	2

### AS-BUILT DRAWING

DATE: 5-1-85  
INSPECTOR: JFP

CANTOR, FITZGERALD  
SECURITIES CORP.  
105TH FLOOR  
ONE WORLD TRADE CENTER, NEW YORK, N.Y.

NEW CORPORATE BOND  
TRADING ROOM  
FURNITURE & ELECTRONIC  
EQUIPMENT PLAN

PROJECT NO. 1357A  
SCALE: 1/4" = 1'-0"  
DRAWN BY: J.F.P.  
CHECKED BY:  
DATE: 12-6-84

DRAWING NO.  
**105F**  
**6**